

**LEGEND**

UNIQUE PARCEL IDENTITY NUMBER

MAP No. 076-01-001



BLOCK No. 02

PARCEL No. 02

76 REFERENCE TO ADJOINING MAP

02 REFERENCE TO BLOCK NUMBER

02 REFERENCE TO PARCEL NUMBER

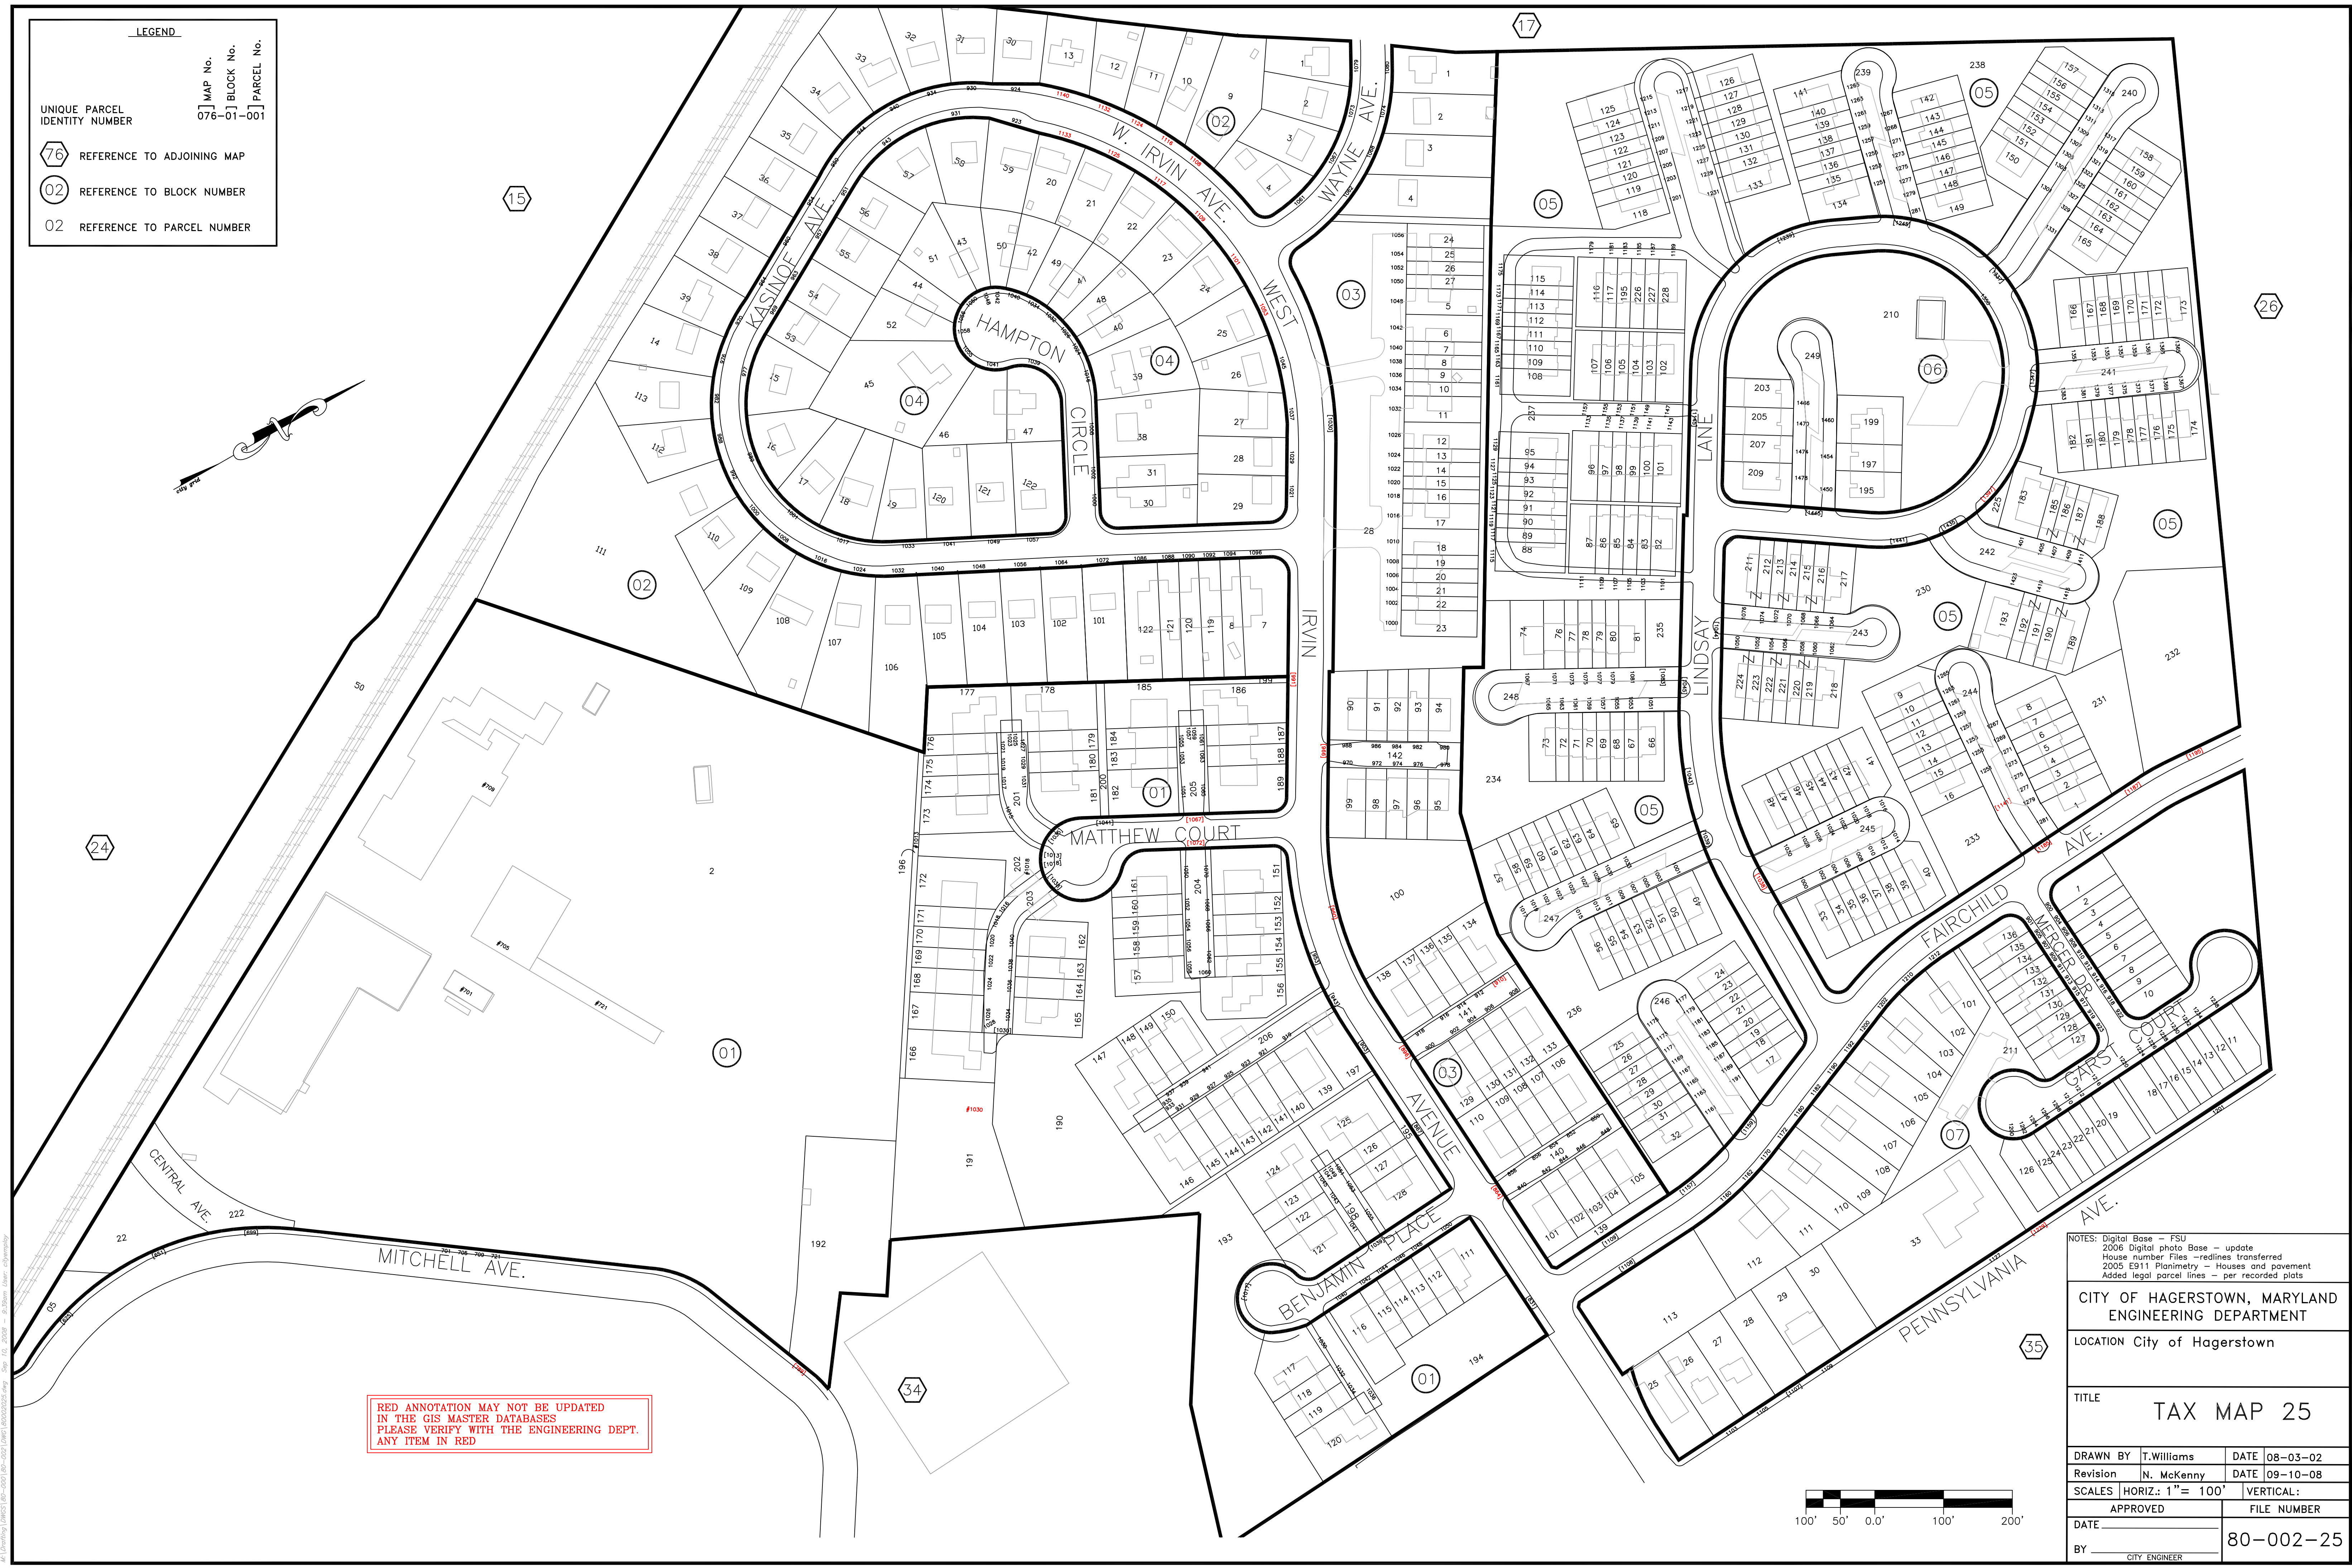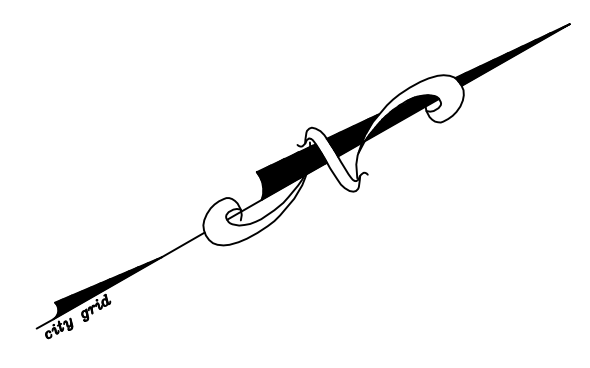

RED ANNOTATION MAY NOT BE UPDATED IN THE GIS MASTER DATABASES. PLEASE VERIFY WITH THE ENGINEERING DEPT. ANY ITEM IN RED

NOTES: Digital Base - FSU  
 2006 Digital photo Base - update  
 House number Files -redlines transferred  
 2005 E911 Planimetry - Houses and pavement  
 Added legal parcel lines - per recorded plats

CITY OF HAGERSTOWN, MARYLAND  
 ENGINEERING DEPARTMENT

LOCATION City of Hagerstown

TITLE  
 TAX MAP 25

DRAWN BY T.Williams DATE 08-03-02

Revision N. McKenny DATE 09-10-08

SCALES | HORIZ.: 1"= 100' | VERTICAL:

APPROVED FILE NUMBER

DATE BY CITY ENGINEER 80-002-25

