


**LEGEND**

|                               |                              |
|-------------------------------|------------------------------|
| UNIQUE PARCEL IDENTITY NUMBER | MAP No. 076-01-001           |
| 76 REFERENCE TO ADJOINING MAP | 02 REFERENCE TO BLOCK NUMBER |
| 02 REFERENCE TO PARCEL NUMBER |                              |

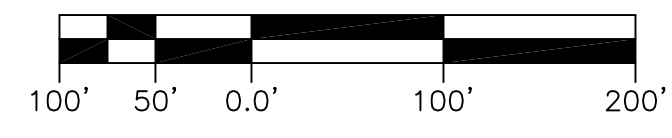

RED ANNOTATION MAY NOT BE UPDATED IN THE GIS MASTER DATABASES PLEASE VERIFY WITH THE ENGINEERING DEPT. ANY ITEM IN RED

NOTES: Digital Base - FSU  
2006 Digital photo Base - update  
House number Files -redlines transferred  
2005 E911 Planimetry - Houses and pavement  
Added legal parcel lines - per recorded plats

**CITY OF HAGERSTOWN, MARYLAND  
ENGINEERING DEPARTMENT**

LOCATION City of Hagerstown

TITLE **TAX MAP 47**

|                          |               |
|--------------------------|---------------|
| DRAWN BY T.Williams      | DATE 04-15-03 |
| Revision N. McKenny      | DATE 09-09-08 |
| SCALES HORIZ.: 1" = 100' | VERTICAL:     |
| APPROVED                 | FILE NUMBER   |
| DATE                     | 80-002-47     |
| BY CITY ENGINEER         |               |