


RED ANNOTATION MAY NOT BE UPDATED
 IN THE GIS MASTER DATABASES
 PLEASE VERIFY WITH THE ENGINEERING DEPT.
 ANY ITEM IN RED

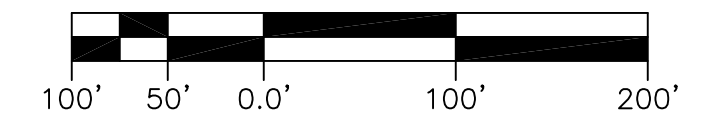

LEGEND	
UNIQUE PARCEL IDENTITY NUMBER	MAP No. BLOCK No. PARCEL No.
76	076-01-001
02	REFERENCE TO BLOCK NUMBER
02	REFERENCE TO PARCEL NUMBER

NOTES: Digital Base - FSU
 2006 Digital photo Base - update
 House number Files - redlines transferred
 2005 E911 Planimetry - Houses and pavement
 Added legal parcel lines - per recorded plats

CITY OF HAGERSTOWN, MARYLAND
 ENGINEERING DEPARTMENT

LOCATION City of Hagerstown

TITLE
 TAX MAP 58

DRAWN BY T. Williams DATE 08-19-03

Revision N. McKenny DATE 09-08-08

SCALES HORIZ.: 1" = 100' VERTICAL:

APPROVED FILE NUMBER

DATE 80-002-58
 BY CITY ENGINEER