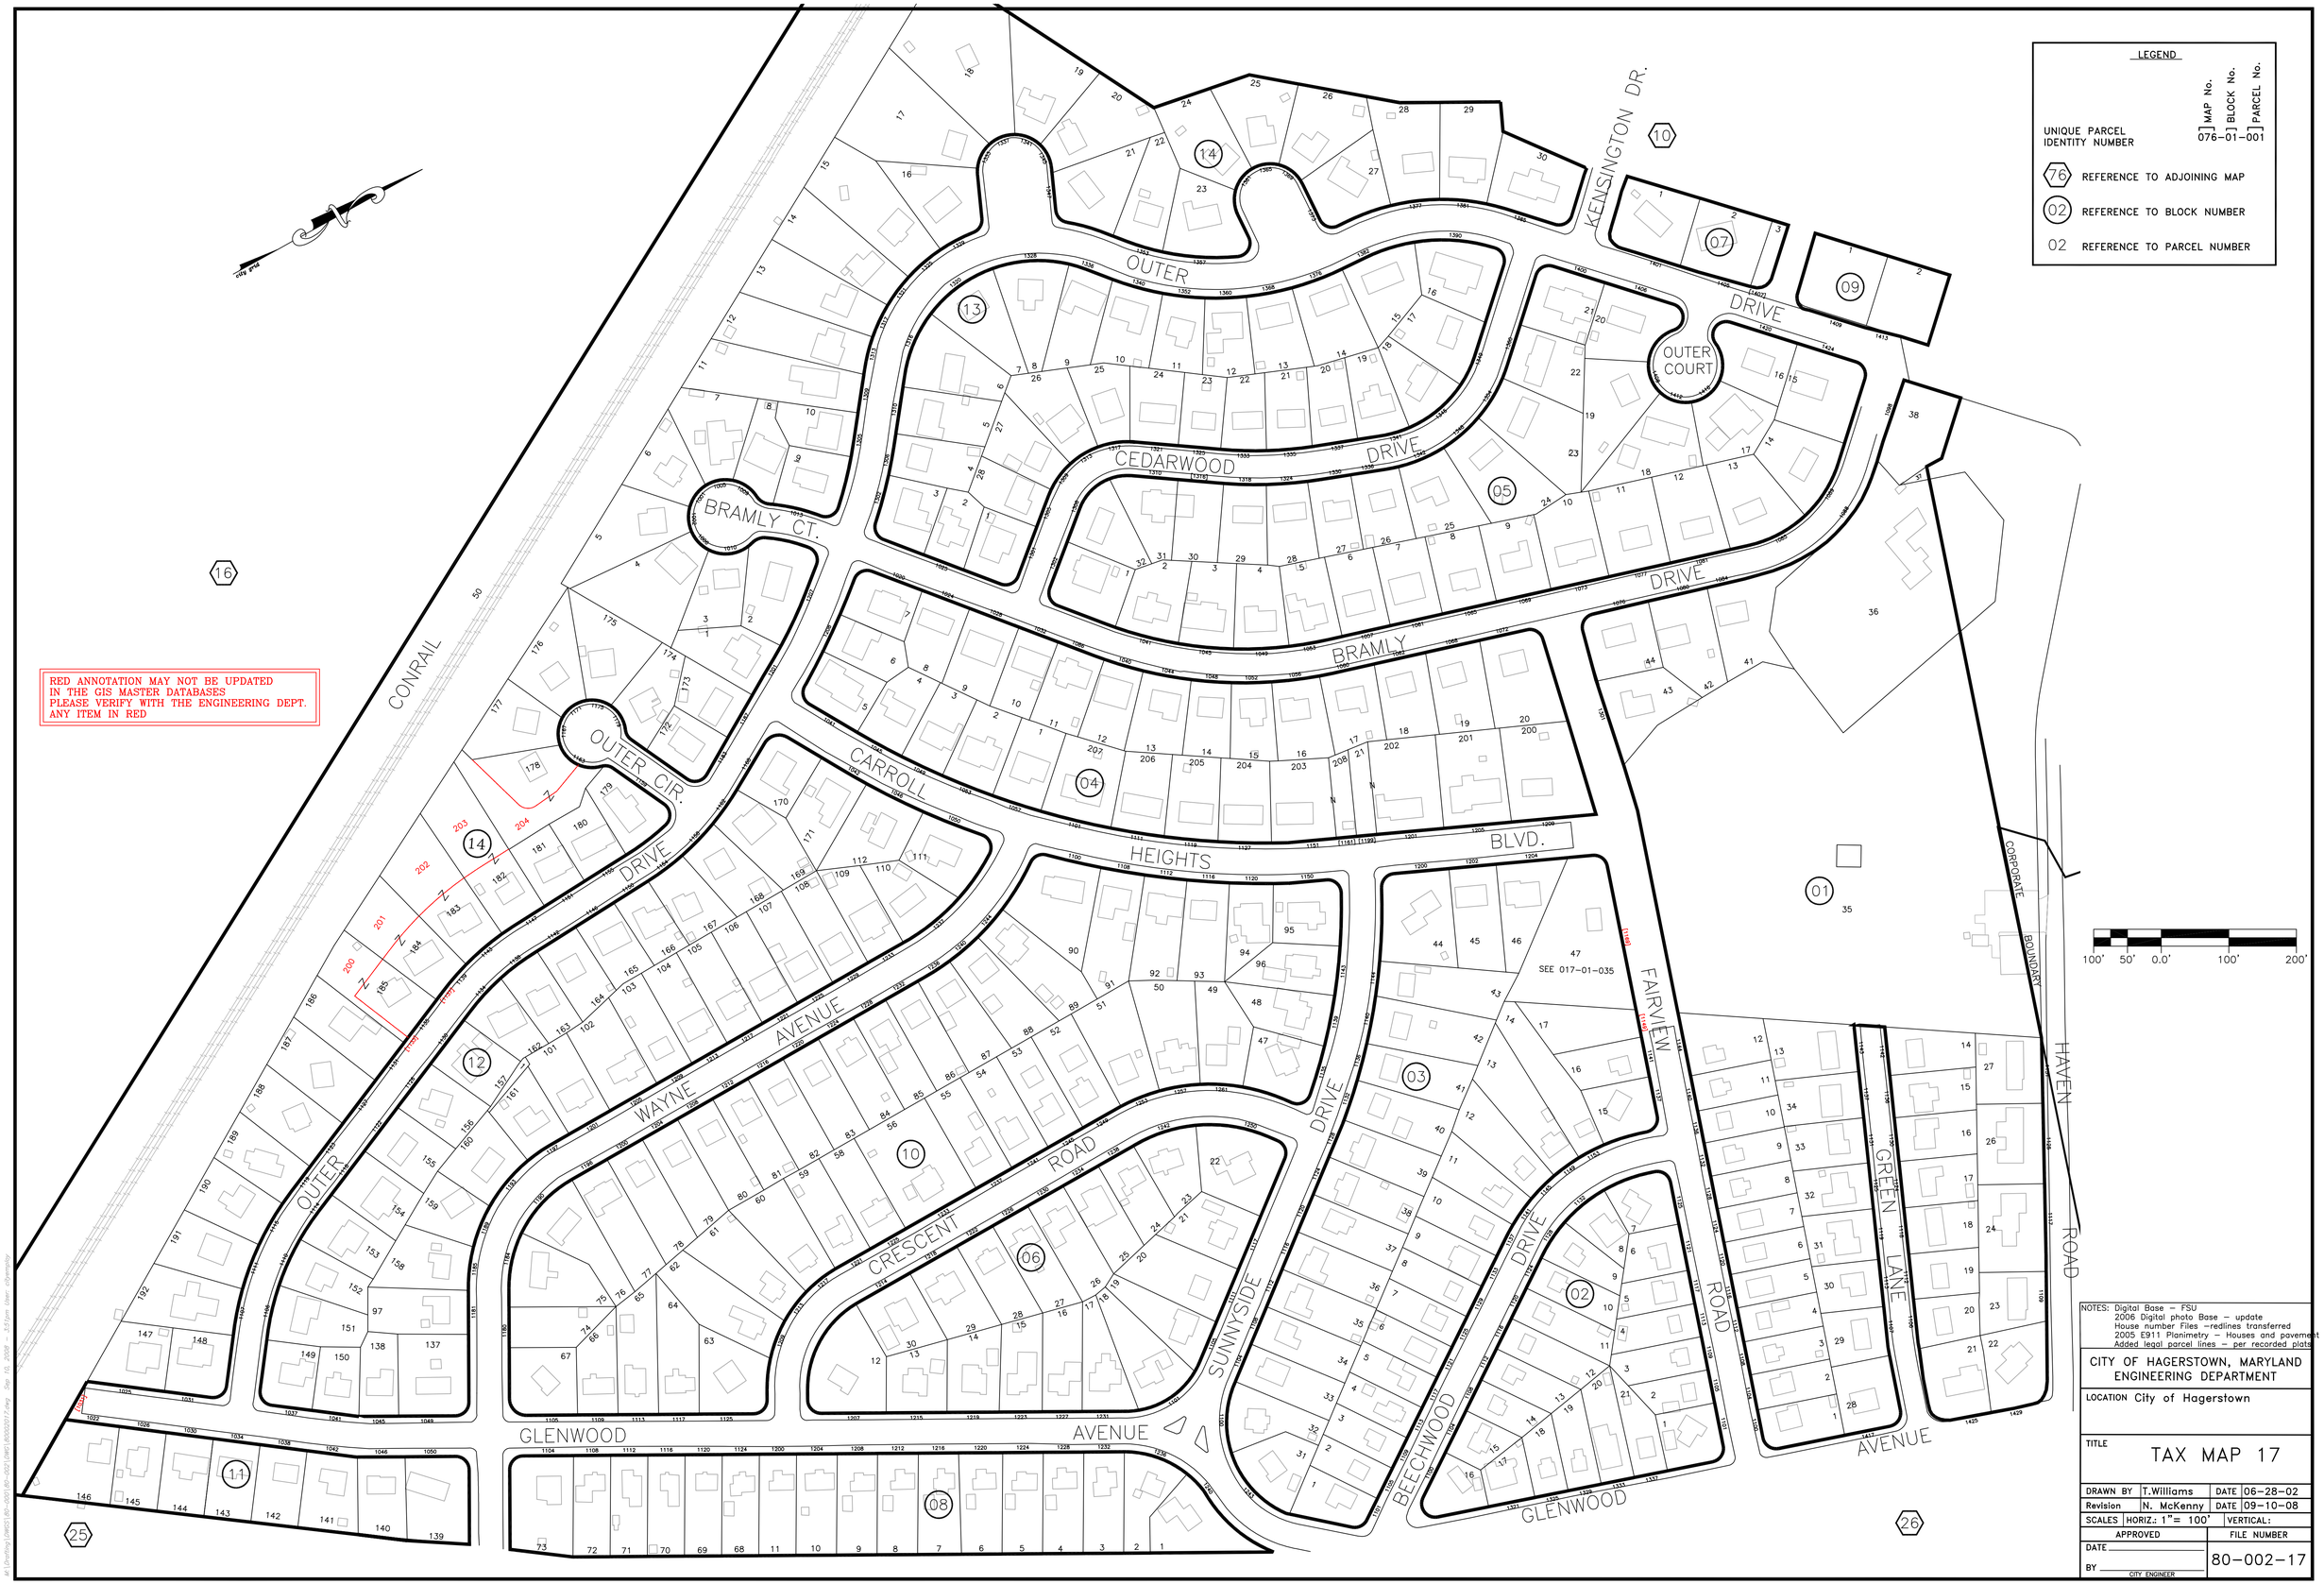
LEGEND
UNIQUE PARCEL IDENTITY NUMBER
MAP No. BLOCK No. PARCEL No.
076-01-001
76 REFERENCE TO ADJOINING MAP
02 REFERENCE TO BLOCK NUMBER
02 REFERENCE TO PARCEL NUMBER
RED ANNOTATION MAY NOT BE UPDATED
IN THE GIS MASTER DATABASES
PLEASE VERIFY WITH THE ENGINEERING DEPT.
ANY ITEM IN RED
CONRAIL
OUTER DRIVE
OUTER COURT
CEDARWOOD DRIVE
BRAMLY CT.
BRAMLY DRIVE
CARROLL HEIGHTS BLVD.
KENSINGTON DR.
OUTER CIR.
WAYNE AVENUE
CRESCENT ROAD
SUNNYSIDE DRIVE
FAIRVIEW ROAD
BEECHWOOD DRIVE
GREEN LANE
GLENWOOD AVENUE
CORPORATE BOUNDARY
HAVEN ROAD
SEE 017-01-035
100' 50' 0.0' 100' 200'
NOTES: Digital Base – FSU
2006 Digital photo Base – update
House number Files –redlines transferred
2005 E911 Planimetry – Houses and pavement
Added legal parcel lines – per recorded plats
CITY OF HAGERSTOWN, MARYLAND
ENGINEERING DEPARTMENT
LOCATION City of Hagerstown
TITLE
TAX MAP 17
DRAWN BY T.Williams DATE 06-28-02
Revision N. McKenny DATE 09-10-08
SCALES HORIZ.: 1"= 100' VERTICAL:
APPROVED
FILE NUMBER
DATE
BY
CITY ENGINEER
80-002-17