



LEGEND	
UNIQUE PARCEL IDENTITY NUMBER	MAP No. 076-01-001
	REFERENCE TO ADJOINING MAP
	REFERENCE TO BLOCK NUMBER
02	REFERENCE TO PARCEL NUMBER

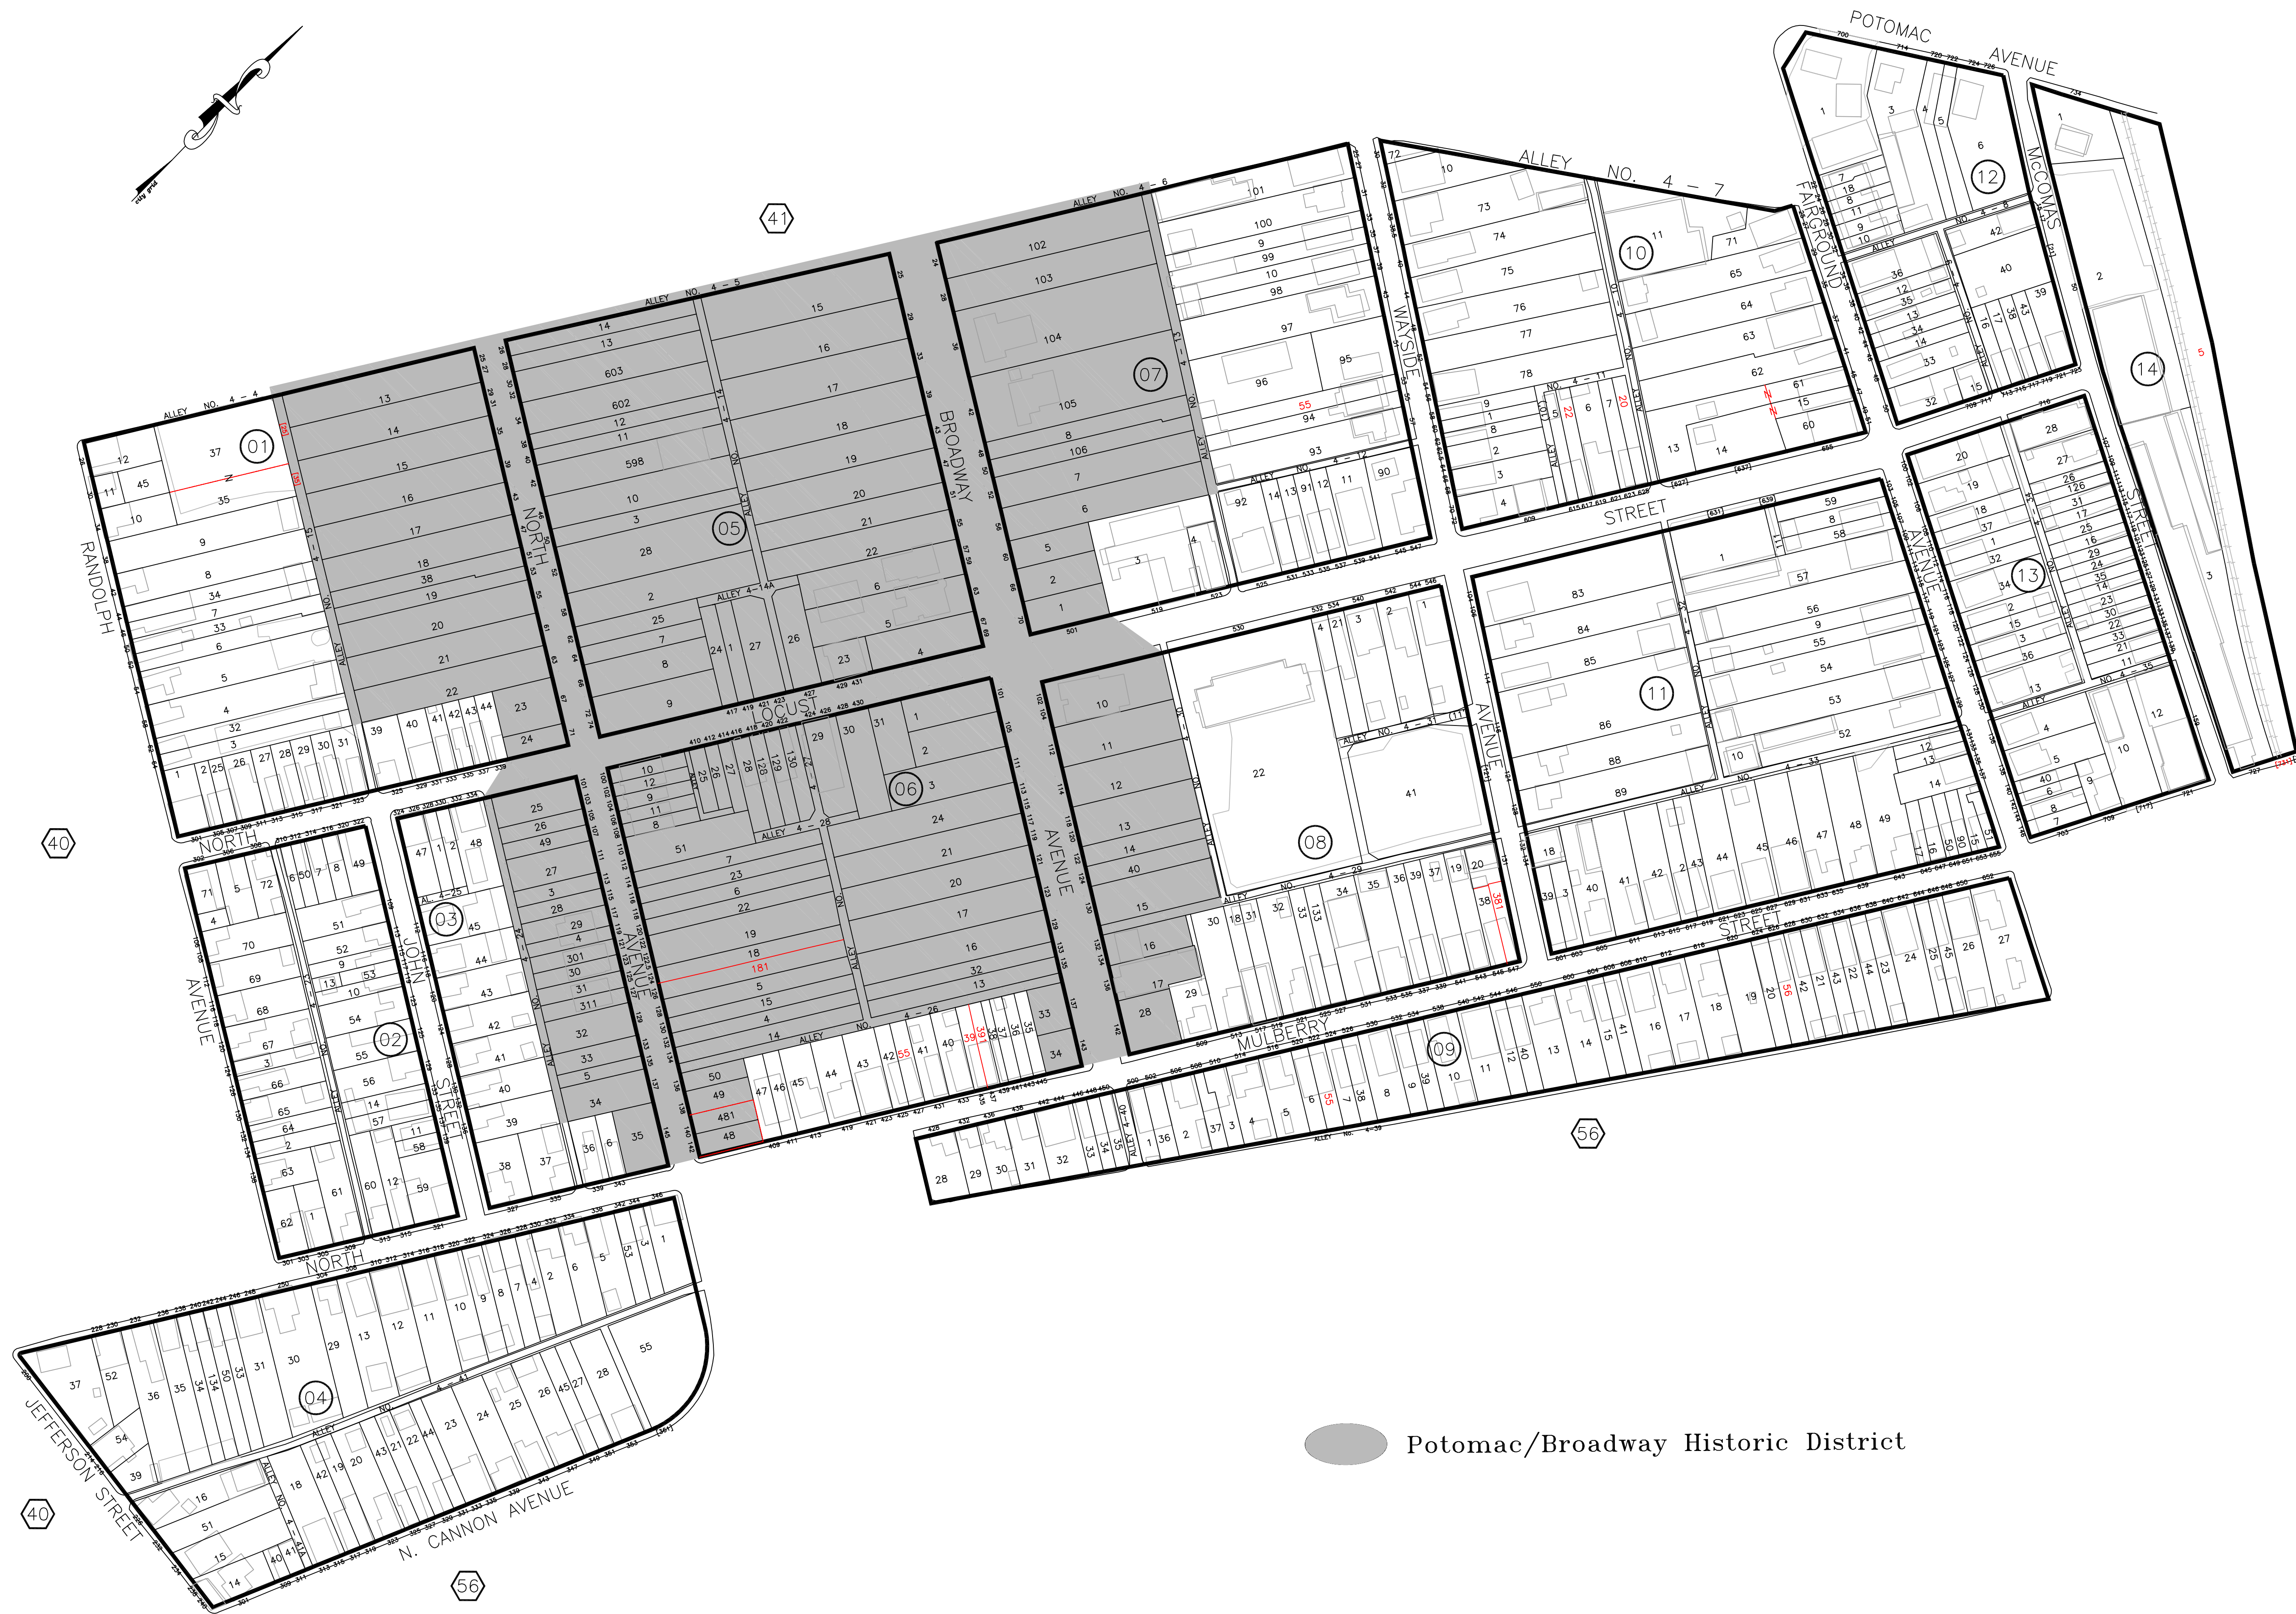

Potomac/Broadway Historic District

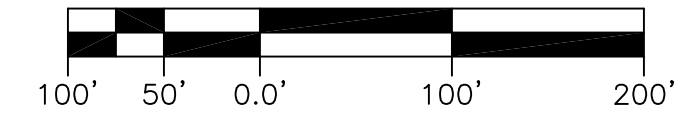

NOTES: Digital Base - FSJ
 2006 Digital photo Base - update
 House number Files - redlines transferred
 2005 E911 Planimetry - Houses and pavement
 Added legal parcel lines - per recorded plats

CITY OF HAGERSTOWN, MARYLAND
 ENGINEERING DEPARTMENT

LOCATION City of Hagerstown

TITLE PUBLIC DIGITAL
 TAX MAP 49

DRAWN BY T. Williams DATE 01-21-03

Revision N. McKenny DATE 09-09-08

SCALES HORIZ.: 1"= 100' VERTICAL:

APPROVED FILE NUMBER

DATE 80-002-049

BY CITY ENGINEER

RED ANNOTATION MAY NOT BE UPDATED
 IN THE GIS MASTER DATABASES
 PLEASE VERIFY WITH THE ENGINEERING DEPT.
 ANY ITEM IN RED