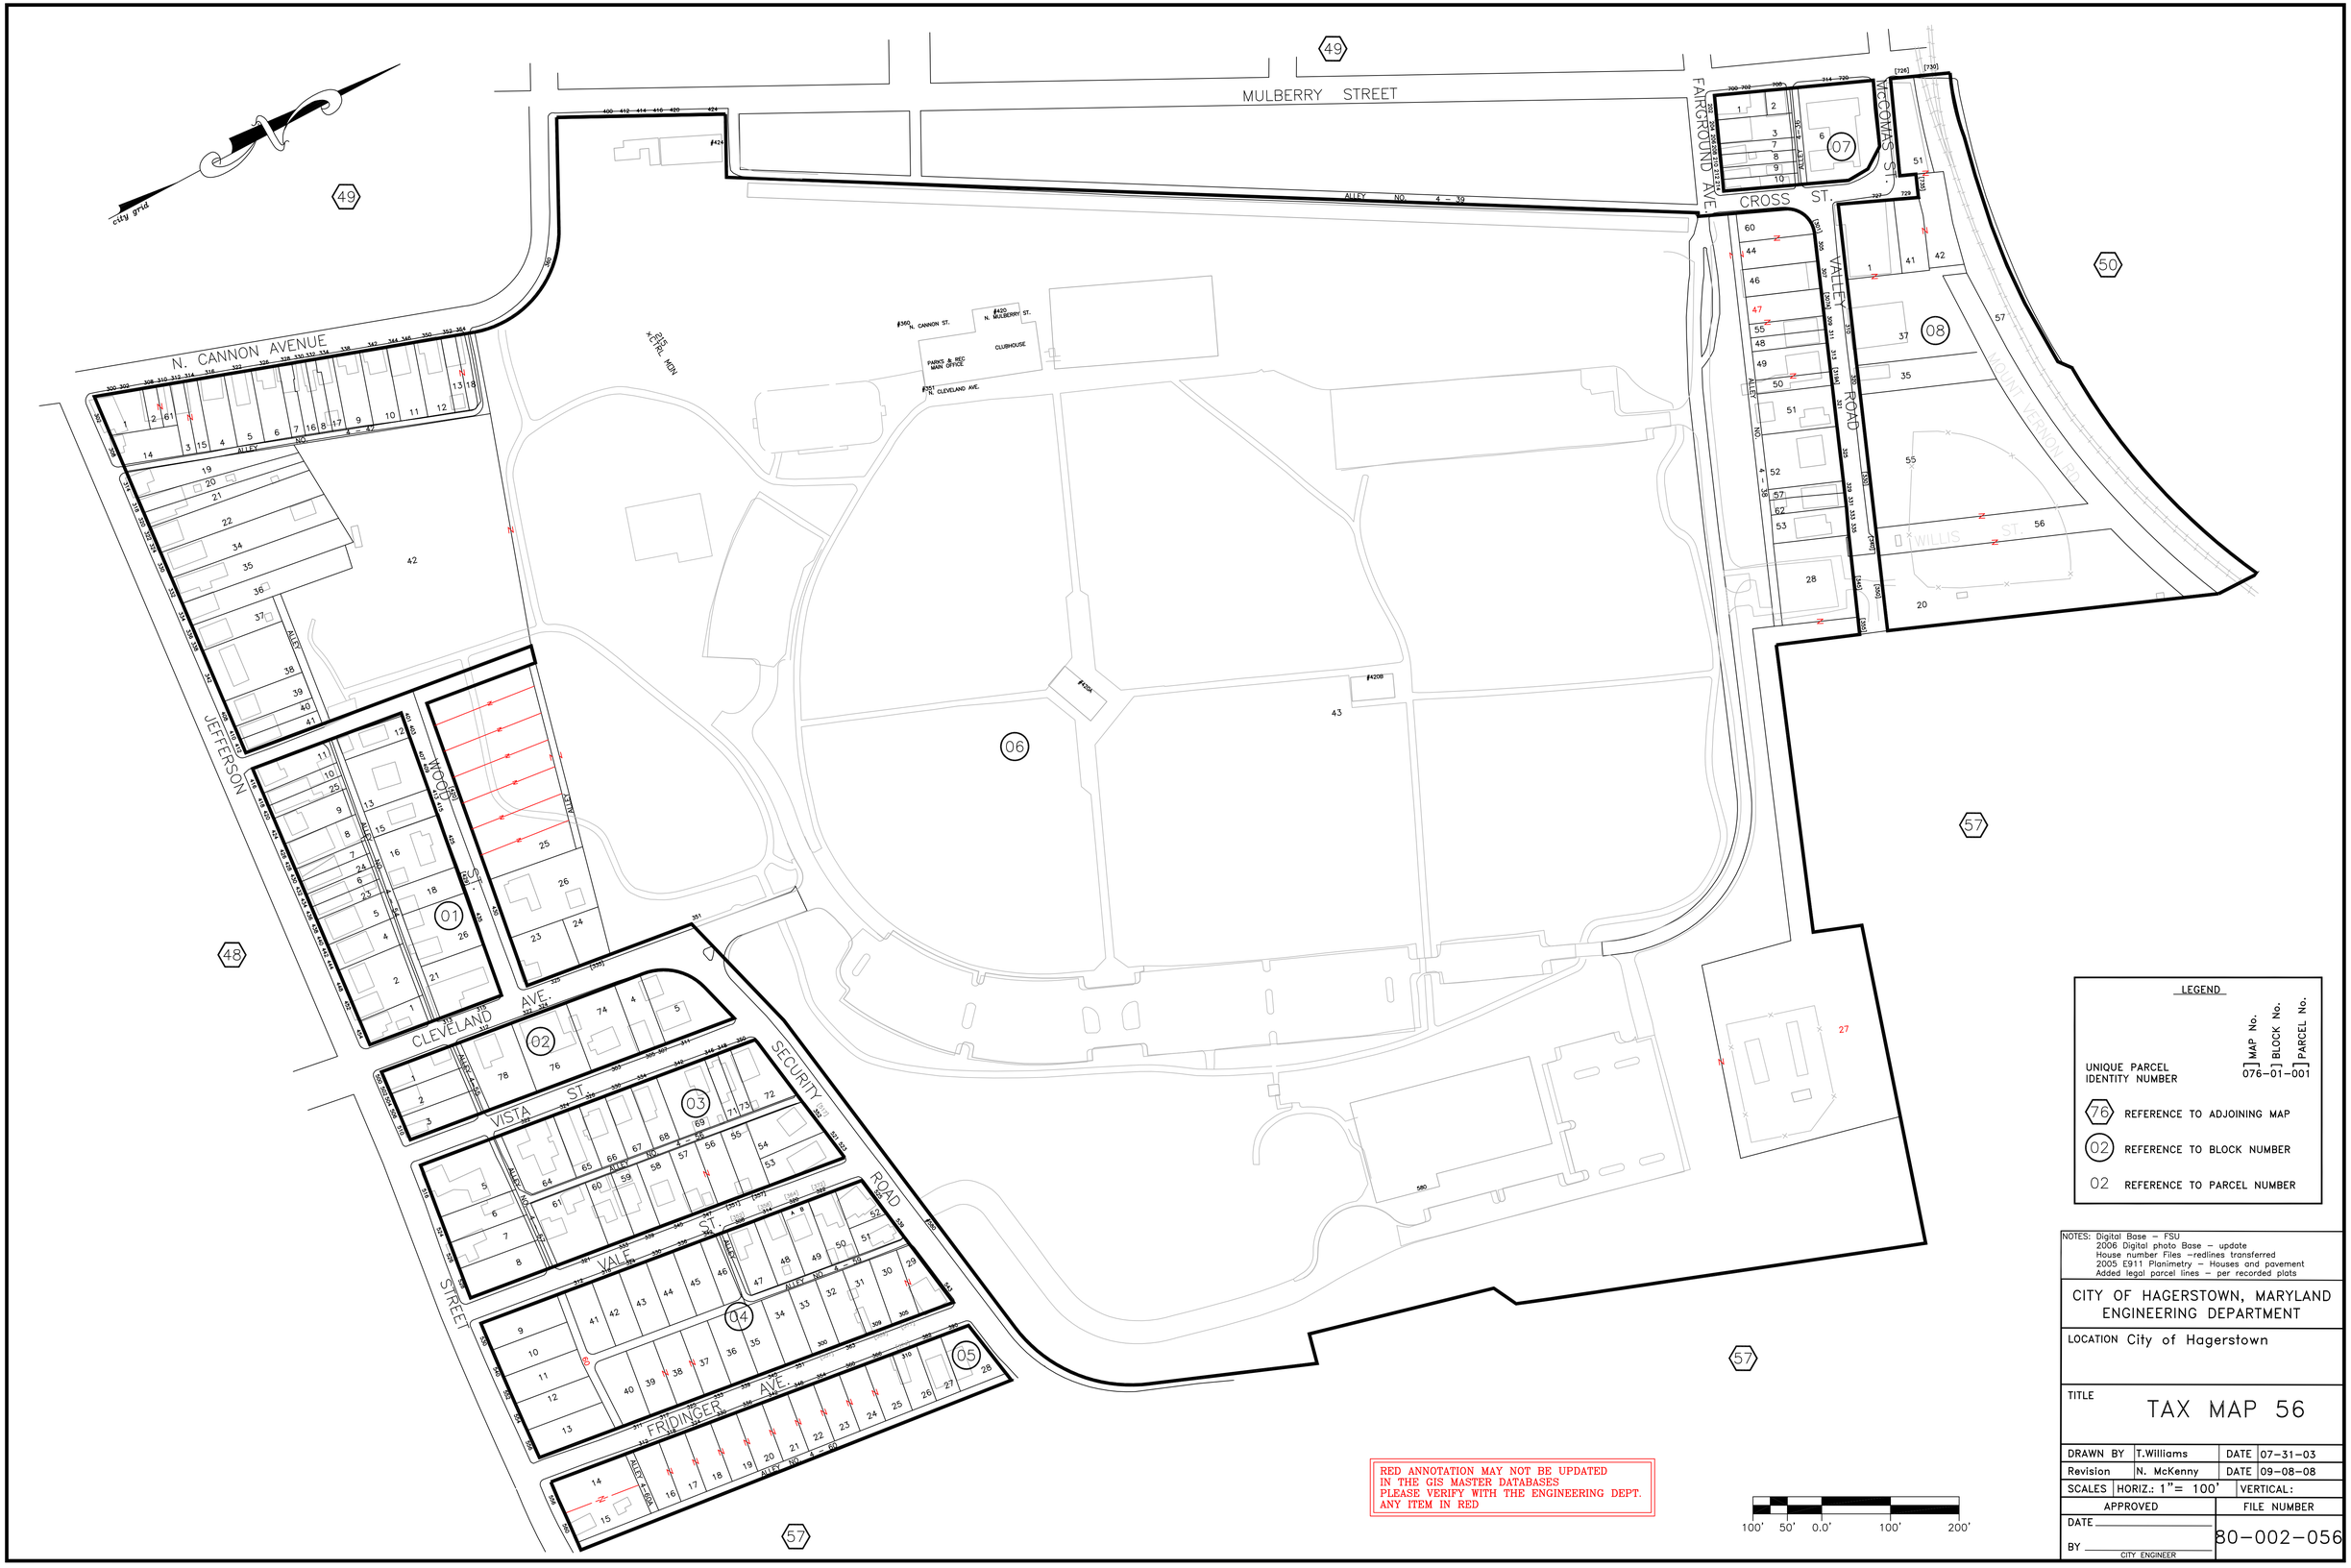

RED ANNOTATION MAY NOT BE UPDATED
IN THE GIS MASTER DATABASES
PLEASE VERIFY WITH THE ENGINEERING DEPT.
ANY ITEM IN RED

100' 50' 0.0' 100' 200'

LEGEND

UNIQUE PARCEL IDENTITY NUMBER — MAP No. / BLOCK No. / PARCEL No. — 076–01–001

76 REFERENCE TO ADJOINING MAP

02 REFERENCE TO BLOCK NUMBER

02 REFERENCE TO PARCEL NUMBER

NOTES: Digital Base – FSU
2006 Digital photo Base – update
House number Files –redlines transferred
2005 E911 Planimetry – Houses and pavement
Added legal parcel lines – per recorded plats

CITY OF HAGERSTOWN, MARYLAND
ENGINEERING DEPARTMENT

LOCATION City of Hagerstown

TITLE

TAX MAP 56

DRAWN BY	T.Williams	DATE	07–31–03
Revision	N. McKenny	DATE	09–08–08
SCALES	HORIZ.: 1"= 100'	VERTICAL:	
APPROVED		FILE NUMBER	
DATE		80–002–056	
BY CITY ENGINEER			