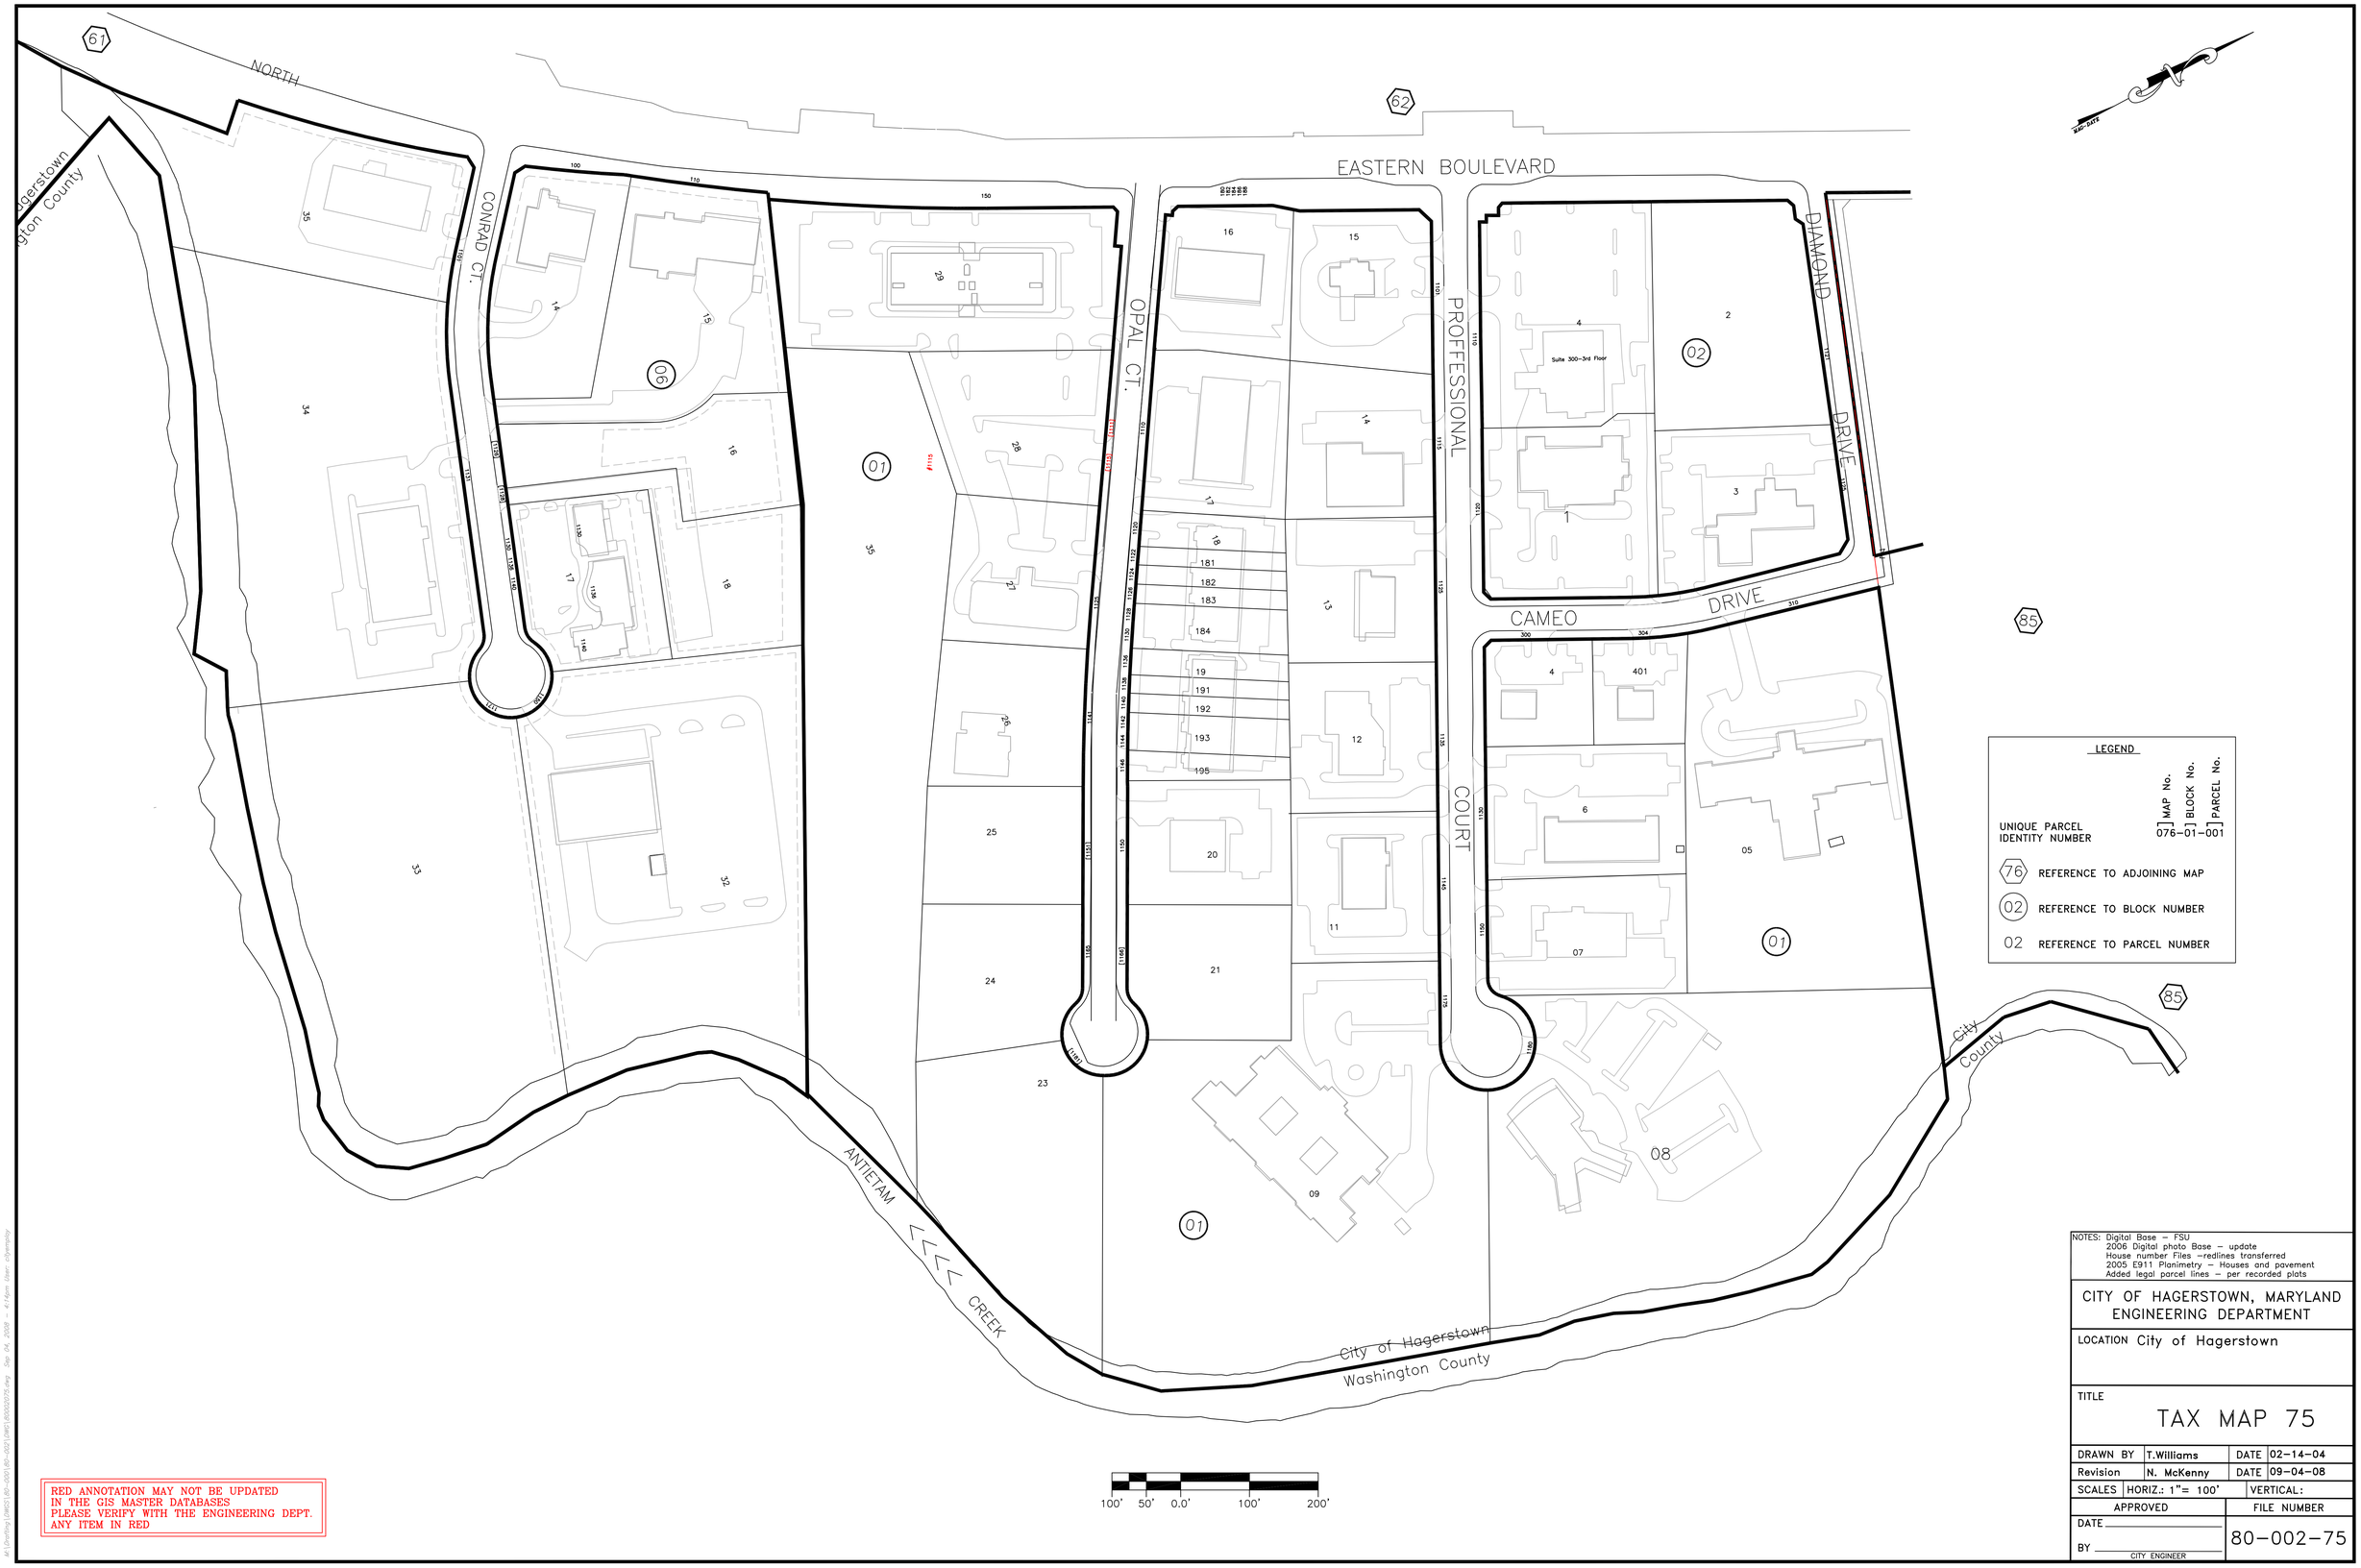

RED ANNOTATION MAY NOT BE UPDATED
IN THE GIS MASTER DATABASES
PLEASE VERIFY WITH THE ENGINEERING DEPT.
ANY ITEM IN RED

NOTES: Digital Base – FSU
2006 Digital photo Base – update
House number Files –redlines transferred
2005 E911 Planimetry – Houses and pavement
Added legal parcel lines – per recorded plats

CITY OF HAGERSTOWN, MARYLAND
ENGINEERING DEPARTMENT

LOCATION City of Hagerstown

TITLE
TAX MAP 75

DRAWN BY	T.Williams	DATE	02-14-04
Revision	N. McKenny	DATE	09-04-08
SCALES	HORIZ.: 1"= 100'	VERTICAL:	
APPROVED		FILE NUMBER	
DATE		80-002-75	
BY	CITY ENGINEER		